
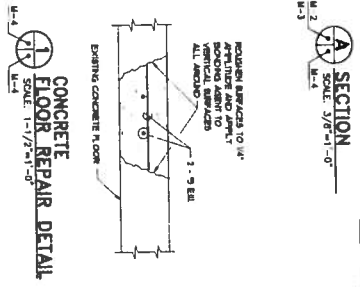


EXHIBIT C

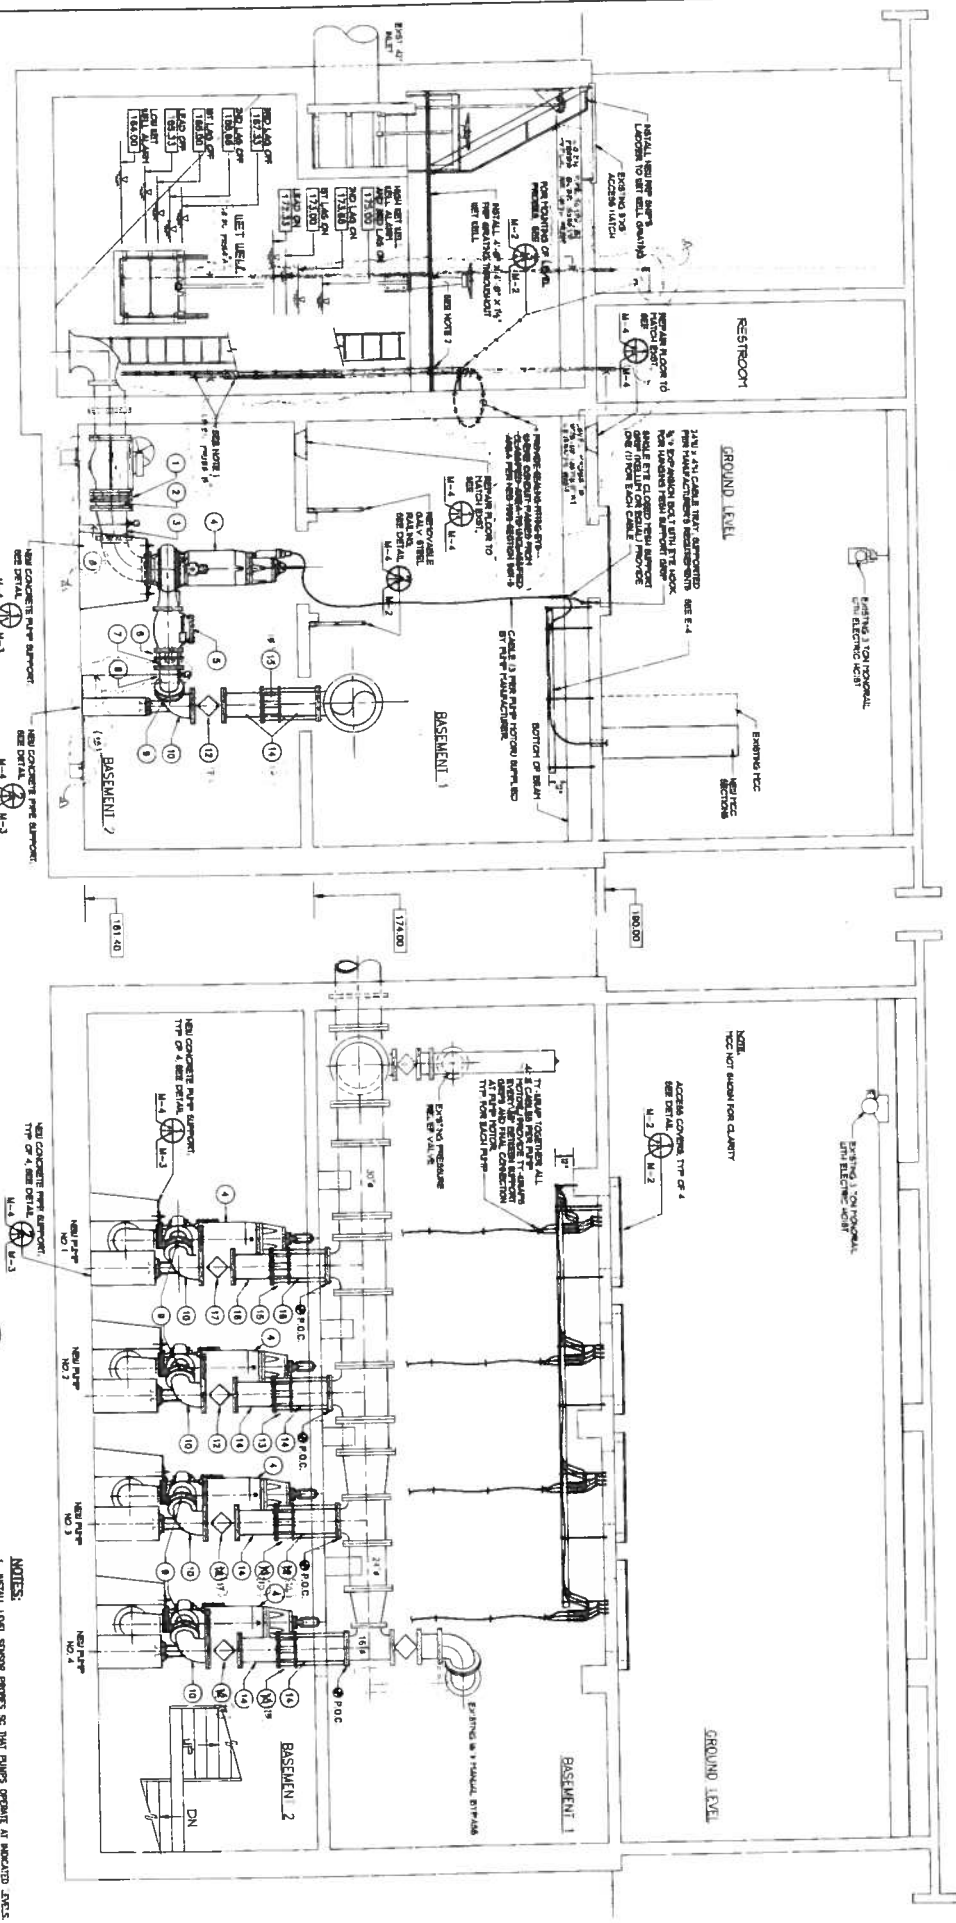

LIST OF MATERIALS

ITEM NO.	DESCRIPTION
1	FOR ITEM NUMBERS 1 TO 10 SEE DRAWING M-3
11	REMOVE EXISTING 18" FLUE VALVE
12	REMOVE EXISTING 18" COUPLING ADAPTER
13	REMOVE EXISTING 18" B SPOOL, FL X 1/2" CUT TO SURF
14	1/8" FLANGED COUPLING ADAPTER WITH THE NIOS
15	1/8" SPOOL, DOUBLE END, FLANGED X PUMP END
16	1/8" FLUE VALVE (SEE SPECIFICATIONS)

NOTES:
 1. INSTALL LEVEL SENSOR PROBES ON THE PIPES ORIENT IN INDICATED DIRECTION.
 2. CUT HOLE IN PIPE DRAWING TO ACCOMMODATE NEW LEVEL SENSOR PROBES.

GRAPHIC SCALE:
 1" = 10'-0"
 1/2" = 5'-0"
 1/4" = 2'-6"

AS-BUILT

DATE: 12/03/99
 DRAWN BY: [Signature]
 CHECKED BY: [Signature]

QUAW WATERWORKS AUTHORITY
 GOVERNMENT OF QUAW

PROJECT: [Project Name]
 LOCATION: [Location]
 SHEET NO. M-4