



GUAM WATERWORKS AUTHORITY

Gloria B. Nelson Public Service Building | 688 Route 15, Mangilao, Guam 96913
P.O. Box 3010, Hagåtña, Guam 96932
Tel. No. (671) 300-6846/48 Fax No. (671) 648-3290

Invitation For Bid: IFB-04-ENG-2026
Project: Asbestos Cement Pipe (ACP) Waterline Replacement- Construction, GWA Project No. 12310
Addendum No.: 03
Date: June 23, 2026

All Potential Bidders:

This addendum is issued to modify the previously issued bid documents and/or given for informational purposes and is hereby made a part of the bid documents. Failure to acknowledge receipt of this addendum shall be grounds for the bidder’s disqualification and rejection of the bidder’s proposal.

1. SECTION 00100- Invitation for Bid and other sections on the bid documents where applies, which states:

“All sealed bids must be submitted through GWA’s Portal in the format stipulated in the IFB document. Bids must be received by GWA no later than 7/2/26 3:00 PM Chamorro Standard Time. The contract time for this project is 240 calendar days for the Base Bid portion of the project.”

“All questions or clarifications must be submitted by email to engbids@guamwaterworks.org or by utilizing Messages in the Portal on or before 6/10/26.”

Has now been changed to read:

“All sealed bids must be submitted through GWA’s Portal in the format stipulated in the IFB document. Bids must be received by GWA no later than 7/17/26 3:00 PM Chamorro Standard Time. The contract time for this project is 240 calendar days for the Base Bid portion of the project.”

“All questions or clarifications must be submitted by email to engbids@guamwaterworks.org or by utilizing Messages in the Portal on or before 7/7/26.”

2. Section 00410 Bid Form supersedes the previously issued Bid Form. See revised Bid Form attached.

3. The following sheets of As-builts will now be included in the **Conceptual Drawings**.

Bidders are also notified to visit GWA website: <http://guamwaterworks.org/bids/> to ensure that all addenda to the bid, answers to questions, and reminders communicated are received by all bidders throughout the solicitation process.


Miguel C. Bordallo, P.E.
General Manager

MCB; eq
Attachments: Revised Bid Form—Addendum No. 3
As-builts included in Conceptual Drawings—Addendum No. 3



BID FORM

Table of Contents

Article 1 - BID RECIPIENT..... 2

Article 2 - BIDDER’S ACKNOWLEDGMENTS 2

Article 3 - BIDDER’S REPRESENTATIONS..... 2

Article 4 - BIDDER’S CERTIFICATIONS..... 3

Article 5 - BASIS OF BID..... 4

Article 6 - TIME OF COMPLETION 4

Article 7 - ATTACHMENTS TO THIS BID..... 4

Article 8 - DEFINED TERMS..... 4

Article 9 - BID SUBMITTAL..... 4

BID FORM

ARTICLE 1 - BID RECIPIENT

1.01 This Bid is submitted to:

Guam Waterworks Authority
Gloria B. Nelson Public Service Building
688 Route 15 Mangilao, Guam 96913

1.02 The undersigned Bidder proposes and agrees, if this Bid is accepted, to enter into a Contract with Buyer in the form included in the Bidding Documents to furnish the Goods and Special Services as specified or indicated in the Bidding Documents, for the prices and within the times indicated in this Bid, and in accordance with the other terms and conditions of the Bidding Documents.

ARTICLE 2 - BIDDER'S ACKNOWLEDGMENTS

2.01 Bidder accepts all of the terms and conditions of the Instructions to Bidders, including without limitation those dealing with the disposition of Bid security. This Bid will remain subject to acceptance for 60 days after the Bid opening, or for such longer period of time that Bidder may agree to in writing upon request of Buyer.

ARTICLE 3 - BIDDER'S REPRESENTATIONS

3.01 In submitting this Bid, Bidder represents that:

A. Bidder has examined and carefully studied the Bidding Documents, Instructions, and related data identified in the Bidding Documents, and has received and acknowledged any and all Amendments, Addenda, or Responses to Request(s) for Information issued from this Bid. At the time of bid submission, all Amendments, Addenda, RFI's issued, and RFI Responses shall be listed by the Bidder utilizing a form similar to the table below:

Addendum No.	Addendum Date		RFI Response No.	RFI Response Date

B. Bidder has visited the Point of Destination and site where the Goods are to be installed or Special Services will be provided and become familiar with and is satisfied as to the observable local conditions that may affect cost, progress, or the furnishing of Goods and Special Services, if required to do so by the Bidding Documents, or if, in Bidder's judgment, any local condition may affect cost, progress, or the furnishing of Goods and Special Services.

C. Bidder is familiar with and is satisfied as to all Laws and Regulations in effect as of the date of the Bid that may affect cost, progress, and the furnishing of Goods and Special Services.

D. Bidder has carefully studied, considered, and correlated the information known to Bidder; information commonly known to sellers of similar goods doing business in the locality of the Point of Destination and the site where the Goods will be installed or where Special Services will be provided; information and observations obtained from Bidder's visits, if any, to the Point of Destination and the site where the Goods will be installed or Special Services will be provided; and any reports and drawings identified in the Bidding Documents regarding the Point of Destination and the site where the Goods will be installed or where Special Services will be provided, with respect to the effect of such information, observations, and documents on the cost, progress, and performance of Seller's obligations under the Bidding Documents.

E. Bidder has given Engineer written notice of all conflicts, errors, ambiguities, and discrepancies that Bidder has discovered in the Bidding Documents, and the written resolution (if any) thereof by Engineer is acceptable to Bidder.

F. The Bidding Documents are generally sufficient to indicate and convey understanding of all terms and conditions for furnishing the Goods and Special Services for which this Bid is submitted.

ARTICLE 4 - BIDDER'S CERTIFICATIONS

4.01 Bidder certifies that:

A. This Bid is genuine and not made in the interest of or on behalf of any undisclosed individual or entity and is not submitted in conformity with any collusive agreement or rules of any group, association, organization, or corporation;

B. Bidder has not directly or indirectly induced or solicited any other Bidder to submit a false or sham Bid;

C. Bidder has not solicited or induced any individual or entity to refrain from bidding; and

D. Bidder has not engaged in corrupt, fraudulent, collusive, or coercive practices in competing for the Contract. For the purposes of this Paragraph 4.01.D:

1. "corrupt practice" means the offering, giving, receiving, or soliciting of any thing of value likely to influence the action of a public official in the bidding process;
2. "fraudulent practice" means an intentional misrepresentation of facts made (a) to influence the bidding process to the detriment of Buyer, (b) to establish bid prices at artificial non-competitive levels, or (c) to deprive Buyer of the benefits of free and open competition;
3. "collusive practice" means a scheme or arrangement between two or more Bidders, with or without the knowledge of Buyer, a purpose of which is to establish bid prices at artificial, non-competitive levels; and
4. "coercive practice" means harming or threatening to harm, directly or indirectly, persons or their property to influence their participation in the bidding process.

ARTICLE 5 - BASIS OF BID

5.01 Bidder will furnish the Goods and Special Services in accordance with the Contract Documents for the following price(s): **See attached Attachment 1 – Unit Price Bid Form**

Bidder acknowledges that estimated quantities are not guaranteed, and are solely for the purpose of comparison of Bids, and final payment for all unit price Bid items will be based on actual quantities, to be determined and as provided in the Contract Documents. Bidder also acknowledges that each unit price includes an amount considered by Bidder to be adequate to cover Bidder’s overhead and profit for each separately identified item.

ARTICLE 6 - TIME OF COMPLETION

6.01 Bidder agrees that the furnishing of Goods and Special Services will conform to the schedule set forth in Article 5 of the Agreement.

6.02 Bidder accepts the provisions of the Agreement as to liquidated damages.

ARTICLE 7 - ATTACHMENTS TO THIS BID

7.01 The following documents are attached to and made a condition of this Bid:

- A. Required Bid security in the form of _____.
- B. List of Proposed Major Suppliers;
- C. Required Bidder Qualification Statement with Supporting Data; and

ARTICLE 8 - DEFINED TERMS

8.01 The terms used in this Bid with initial capital letters have the meanings stated in the Instructions to Bidders, the General Conditions, and the Supplementary Conditions.

ARTICLE 9 - BID SUBMITTAL

9.01 This Bid submitted by:

If Bidder is:

An Individual

Name (typed or printed): _____

By: _____
(Individual’s signature)

Doing business as: _____

Business address: _____

Phone: _____ Facsimile: _____
E-mail address: _____

A Partnership

Partnership Name: _____ (SEAL)

By: _____
(Signature of general partner - attach evidence of authority to sign)

Name (typed or printed): _____

Business address: _____

Phone: _____ Facsimile: _____

E-mail address: _____

A Corporation

Corporation Name: _____

State of Incorporation: _____

Type (General Business, Professional, Service, other): _____

By: _____
(Signature - attach evidence of authority to sign)

Name (typed or printed): _____

Title: _____

(CORPORATE SEAL)

Attest _____
(Signature of Corporate Secretary)

Business address: _____

Phone: _____ Facsimile: _____

E-mail address: _____

A Limited Liability Company (LLC)

LLC Name: _____

State in which organized: _____

By: _____
(Signature - attach evidence of authority to sign)

Name (typed or printed): _____

Title: _____

Business address: _____

Phone: _____ Facsimile: _____
E-mail address: _____

A Joint Venture

First Joint Venturer Name: _____ (SEAL)

By: _____
(Signature - attach evidence of authority to sign)

Name (typed or printed): _____

Title: _____

Business address: _____

Phone: _____ Facsimile: _____

E-mail address: _____

Second Joint Venturer Name: _____ (SEAL)

By: _____
(Signature - attach evidence of authority to sign)

Name (typed or printed): _____

Title: _____

Business address: _____

Phone: _____ Facsimile: _____

E-mail address: _____

Phone and Facsimile Number, and Address for receipt of official communications to Joint Venture: _____

(Each joint venturer must sign. The manner of signing for each individual, partnership, corporation, and limited liability company that is a party to the joint venture should be in the manner indicated above.)

Attachment 1 – Unit Price Bid Form

Asbestos Cement Pipe (ACP) Waterline Replacement- Construction

GWA Project No.12310

Base Bid - Description of Work:

The base bid items consist of but not specifically limited to the construction of new water lines and the removal of existing asbestos cement water line pipes. The installation of fiber optic conduits will also be performed. Work consists of replacement of asbestos cement pipe with PVC pipe by Close Tolerance Pipe Slurrification and Horizontal Directional Drilling methods, including pipe fittings, valves, fire hydrants, manholes, disconnection and re-connection of existing customer service lines, disposal of asbestos material, installation of fiber optic conduits and handholes, and providing temporary bypass and traffic control as necessary to complete the work.

Bidders will complete the work for the following price(s) as broken down per scope item:


Item No.	Description	Unit	Unit Price	Qty	Bid Amount
0.0 - General Conditions					
0.1	Building Permit	LS		1	
0.2	Mobilization/Demobilization	LS		1	
0.3	Insurance and Bonds	LS		1	
0.4	Permits	LS		1	
0.5	Traffic Control	LS		1	
0.6	Erosion Control	LS		1	
0.7	Archaeological monitoring	LS		1	
1.0 – Civil					
1.1	Installation of 12" diameter PVC pipe, installed by Close Tolerance Pipe Slurrification (CTPS), including installation of PVC pipe, testing, and all incidentals, in place complete.	LF		4159	
1.2	Pre-pipeline inspection	LS		1	
1.3	Stop, dig, removal of repair coupling, and restart CTPS	EA		10	
1.4	8" by-pass line, including testing, disinfection, location and connection of services, and excavation and restoration for driveway and roadway crossings. Service saddles turned over to GWA.	LS		1	
1.5	Installation of 12" diameter	LF		1388	

Item No.	Description	Unit	Unit Price	Qty	Bid Amount
	PVC pipe and two 4" fiber optic conduit, installed by Horizontal Directional Drilling (HDD) in one 20" casing, including installation and removal of by-pass system, installation of PVC pipe, casing end seals, testing, and all incidentals, in place complete.				
1.6	Excavation, removal and disposal of ACP at Liyog bridge	LF		595	
1.7	Removal and disposal of DIP and pipe support on Liyog bridge	LF		95	
1.8	Excavation, removal and disposal of ACP at Ajayan bridge	LF		585	
1.9	Removal and disposal of DIP and pipe support on Ajayan bridge	LF		105	
1.10	Fire hydrant assembly	EA		9	
1.11	12" gate valve	EA		15	
1.12	Combination air release/vacuum valve	EA		6	
1.13	12" 11.25 bend	EA		4	
1.14	Service connections	EA		9	
1.15	12x6 tee	EA		2	
1.16	6" gate valve	EA		2	
1.17	12x8 tee	EA		4	
1.18	8" gate valve	EA		4	
1.19	Testing manhole	EA		2	
1.20	Installation of 4" diameter PVC fiber optic duct bank, installed by open trench, concrete encased, and all incidentals, in place complete.	LF		4159	
1.21	Fiber optic handholes	EA		7	
1.22	Disposal of asbestos containing material	TON		48	
1.23	Connections to existing pipe	EA		4	
1.24	Disinfection and testing	LS		1	

Item No.	Description	Unit	Unit Price	Qty	Bid Amount
1.25	Pavement restoration, full lane	LS		1	
TOTAL BASE BID (TOTAL of items 0 through 2.6, inclusive)					
(Please write out total bid amount in words below)					


This Contract will be awarded to the lowest responsive and responsible bidder based on the total Base Bid Schedule. Determination of the lowest responsive and responsible bidder will be in accordance with the provisions of the Bid Documents.

Bidder acknowledges that estimated quantities are not guaranteed, and are solely for the purpose of comparison of Bids, and final payment for all unit price Bid items will be based on actual quantities, determined as provided in the Contract Documents. Bidder also acknowledges that each unit price includes an amount considered by Bidder to be adequate to cover Bidder’s overhead and profit for each separately identified item.

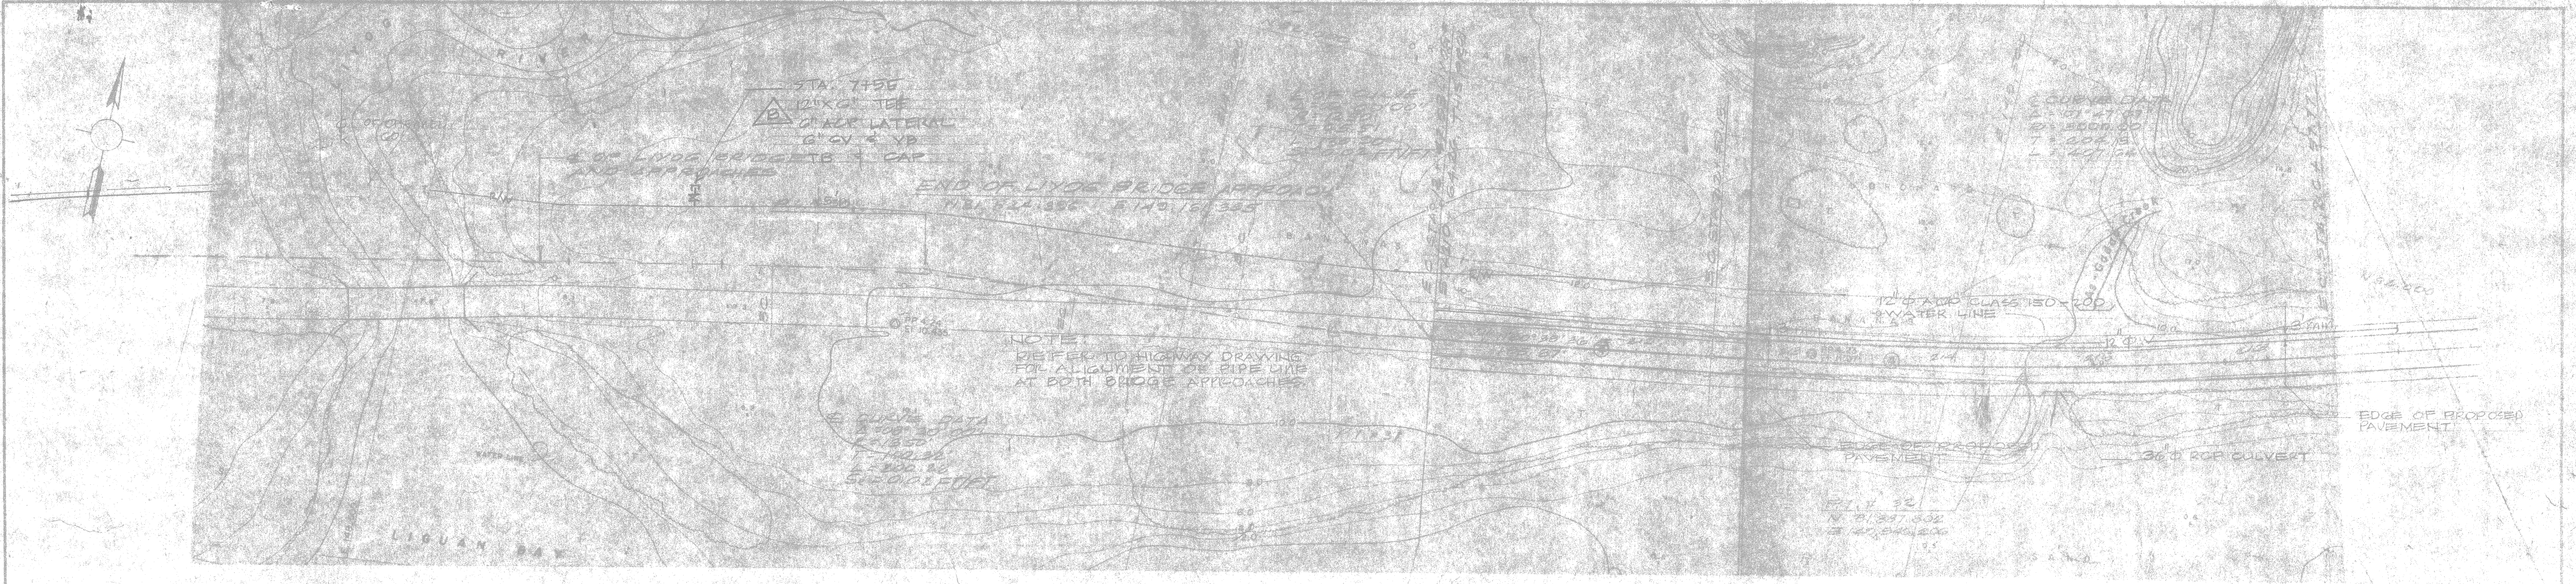


CONSTRUCTION OF LIYOG BRIDGE & APPROACH
 SEE PROJECT NO. TER-F-002 (15)
 CONTRACT NO. PWR 330-75

PLAN
 SCALE: 1" = 50'-0"

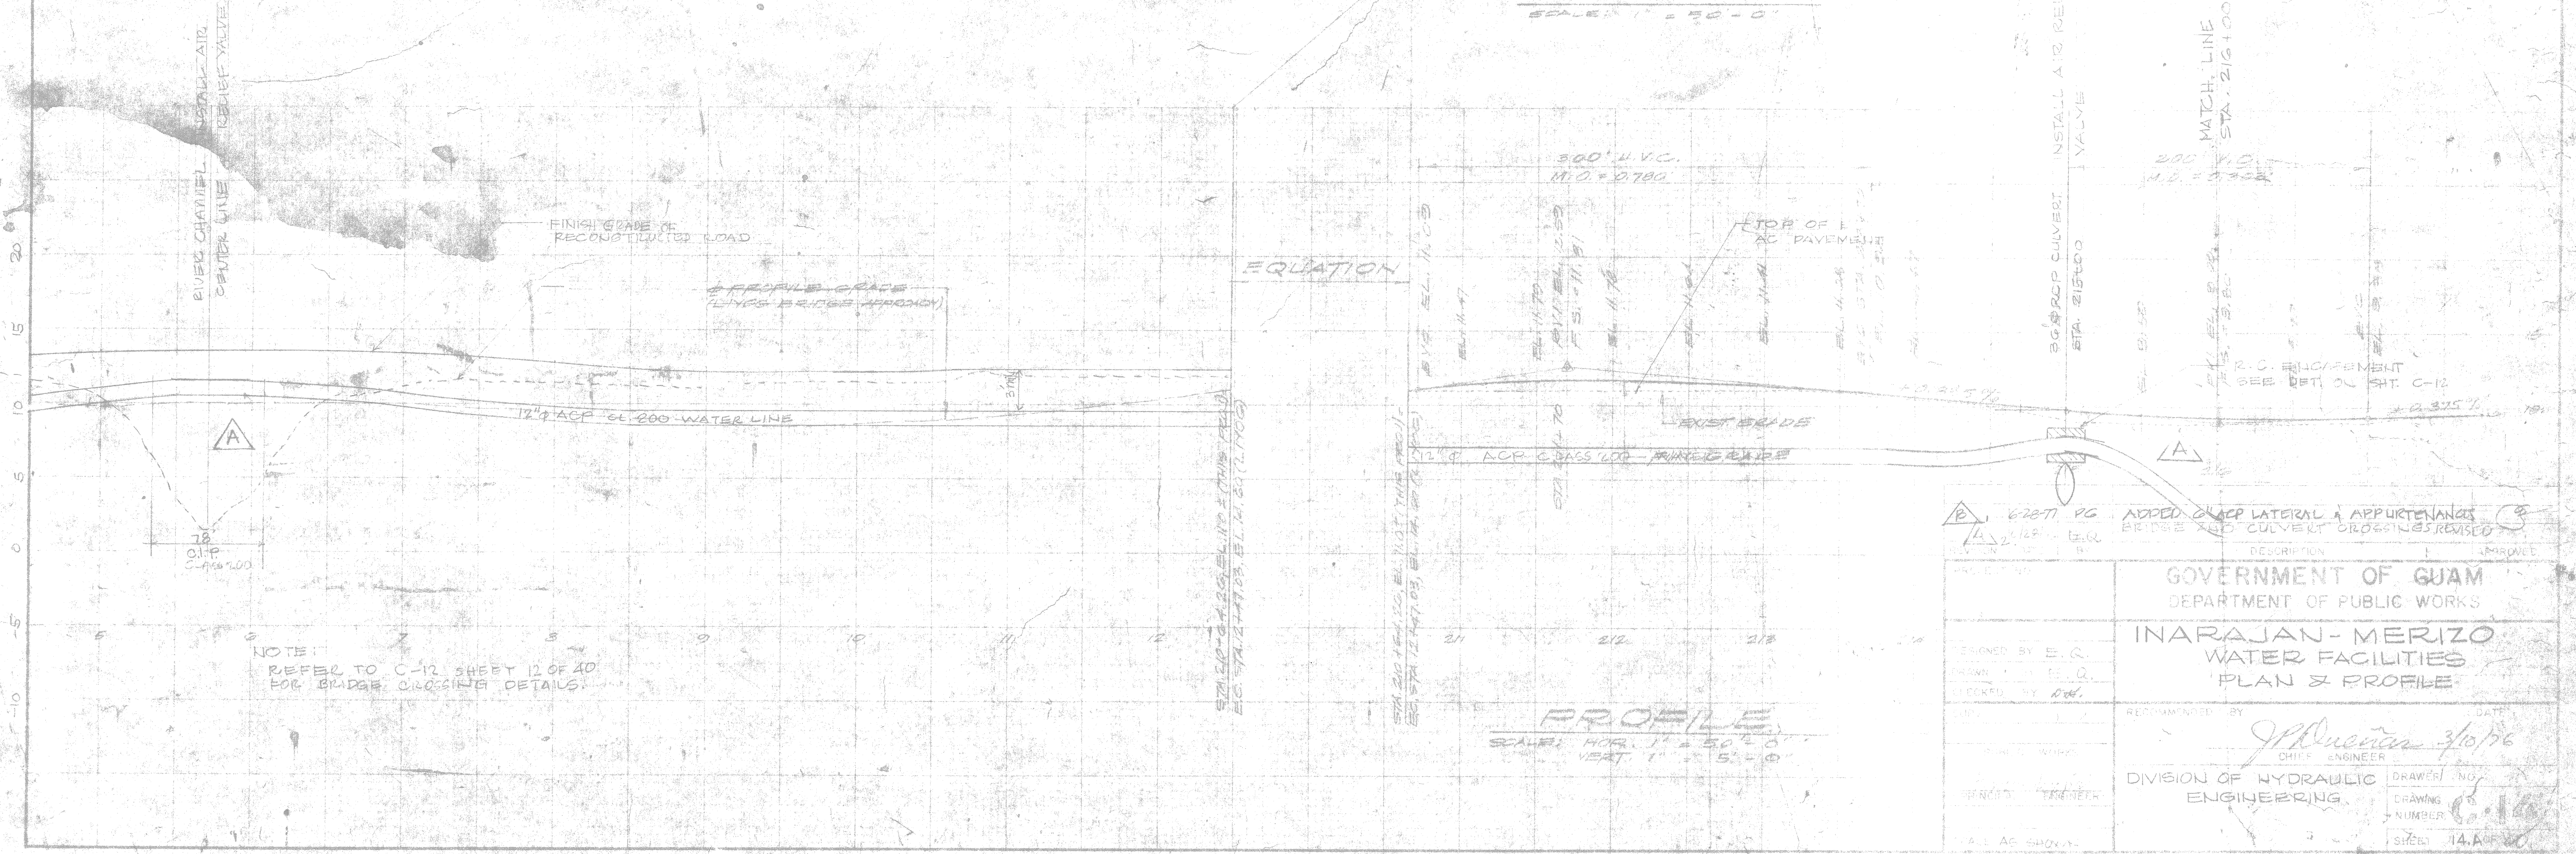


PROFILE
 SCALE: HOR. 1" = 50'-0"
 VERT. 1" = 5'-0"

PROJECT NO.	62871 PG	ADDED 12\"/>	
DESIGNED BY	E. Q.	INARAJAN-MERIZO	
DRAWN BY	E. Q.	WATER FACILITIES	
CHECKED BY	DR.	PLAN & PROFILE	
DATE	1/12/76	RECOMMENDED BY	<i>J. Merizo</i> 3/10/76
CHIEF ENGINEER		DIVISION OF HYDRAULIC ENGINEERING	
DRAWING NUMBER			
SHEET	14A		

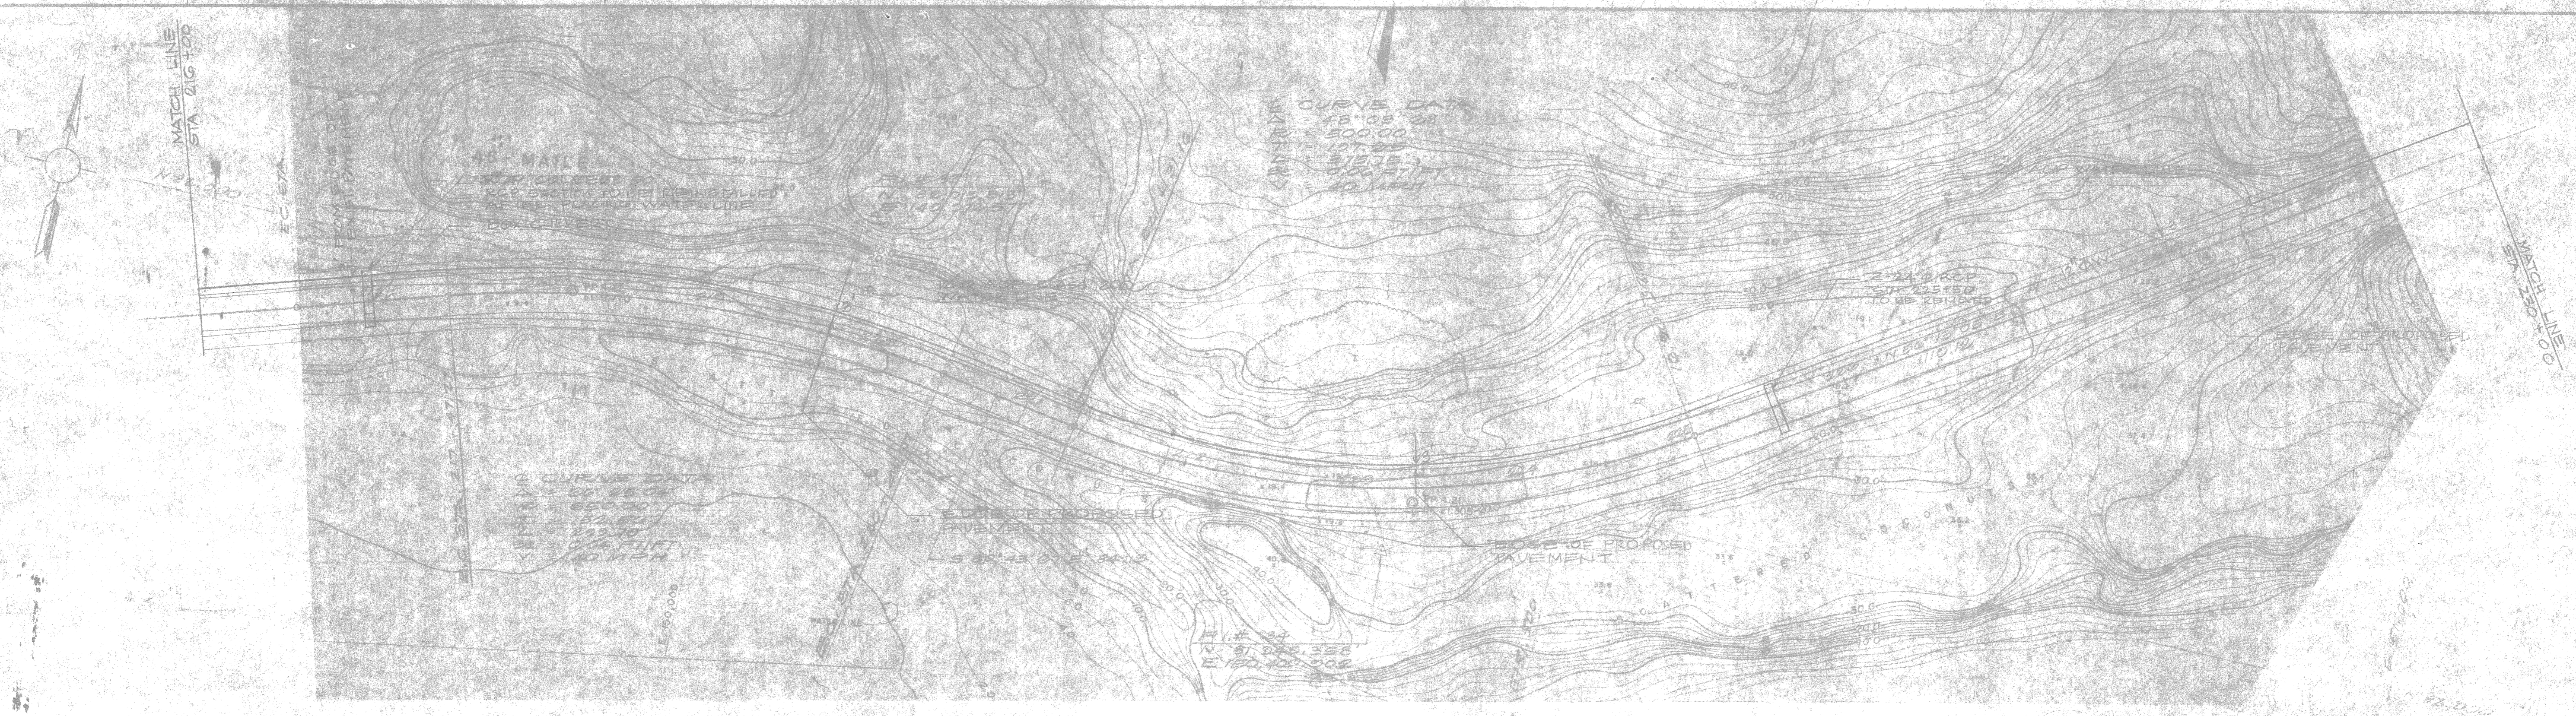


PLAN
SCALE: 1" = 50.00'

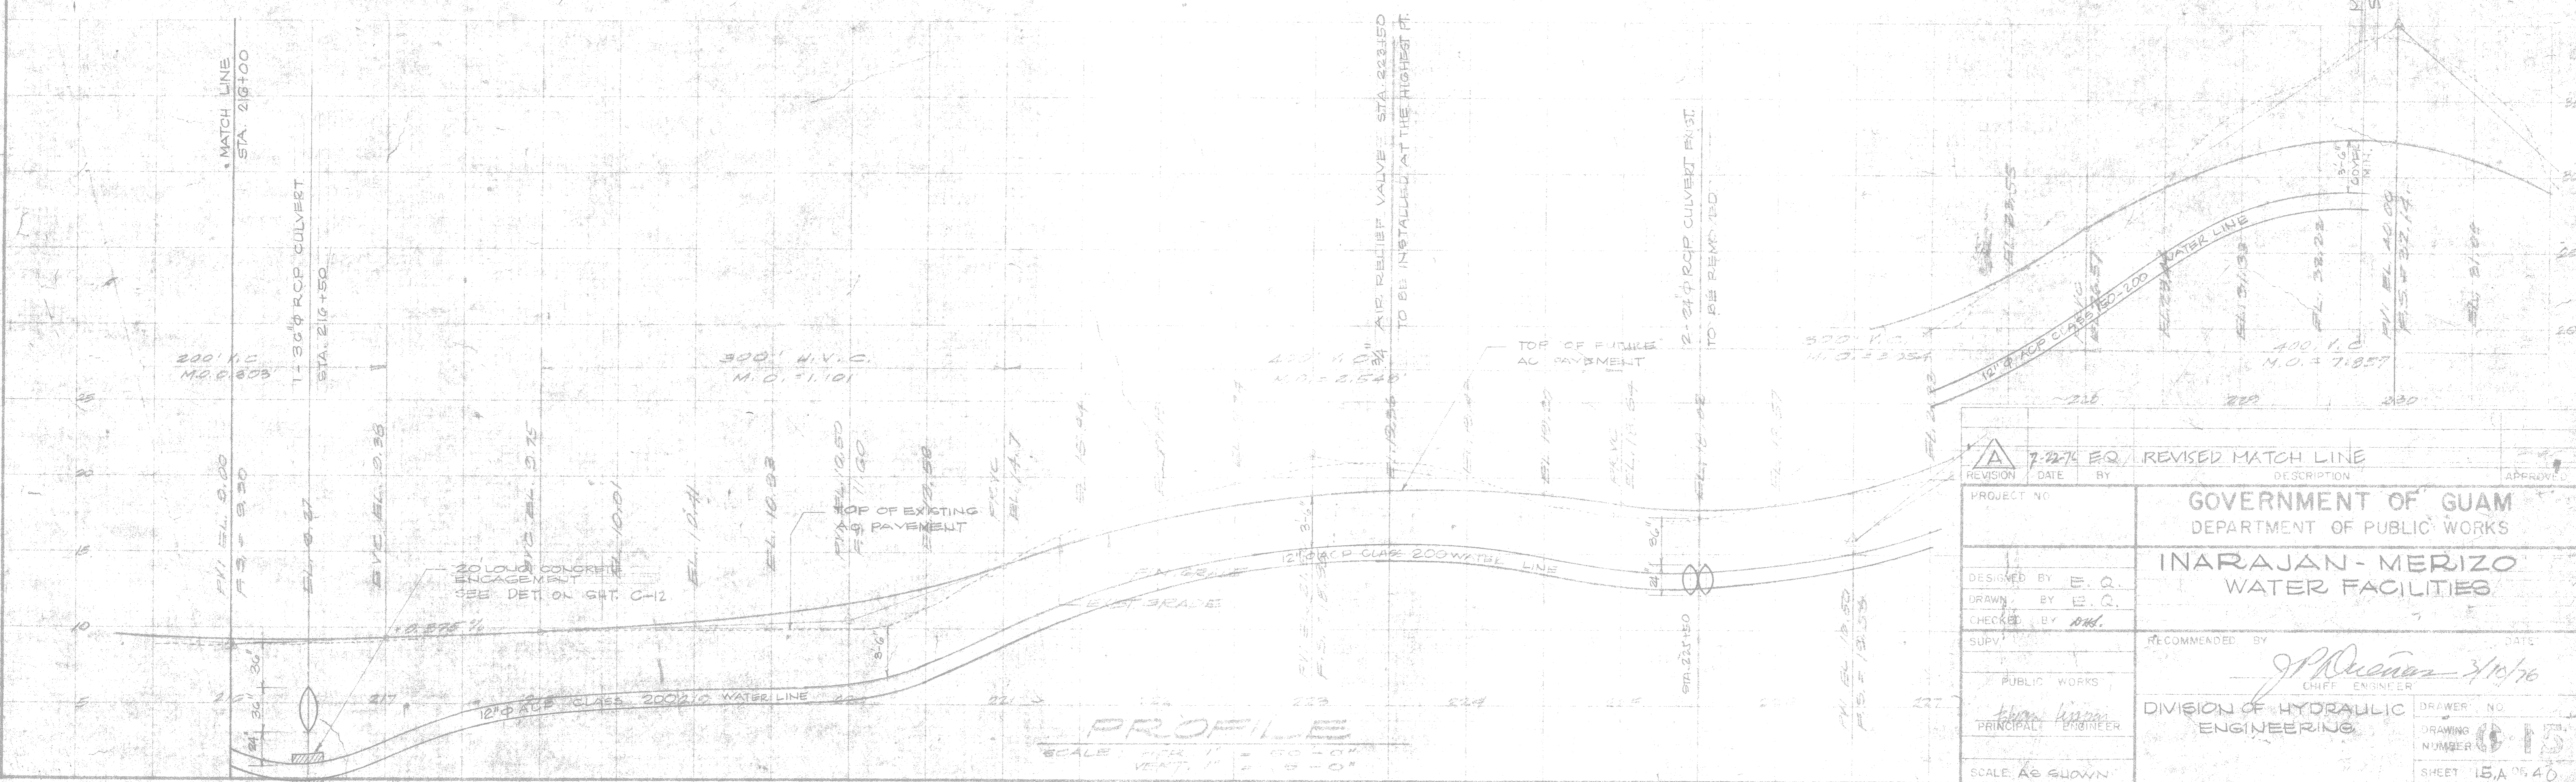


PROFILE
SCALE: HORIZ. 1" = 50.00'
VERT. 1" = 5.00'

REVISION	7-22-74	EQ	REVISED MATCH LINE	APPROVED
PROJECT NO.	GOVERNMENT OF GUAM DEPARTMENT OF PUBLIC WORKS INARAJAN-MERIZO WATER FACILITIES			
DESIGNED BY	E. Q.			
DRAWN BY	E. Q.			
CHECKED BY	R.M.			
SUPV.	RECOMMENDED BY			
PUBLIC WORKS	DATE			
PRINCIPAL ENGINEER	 CHIEF ENGINEER			
SCALE AS SHOWN	DIVISION OF HYDRAULIC ENGINEERING			
	DRAWER NO.			
	DRAWING NUMBER 015			
	SHEET 15A OF 40			



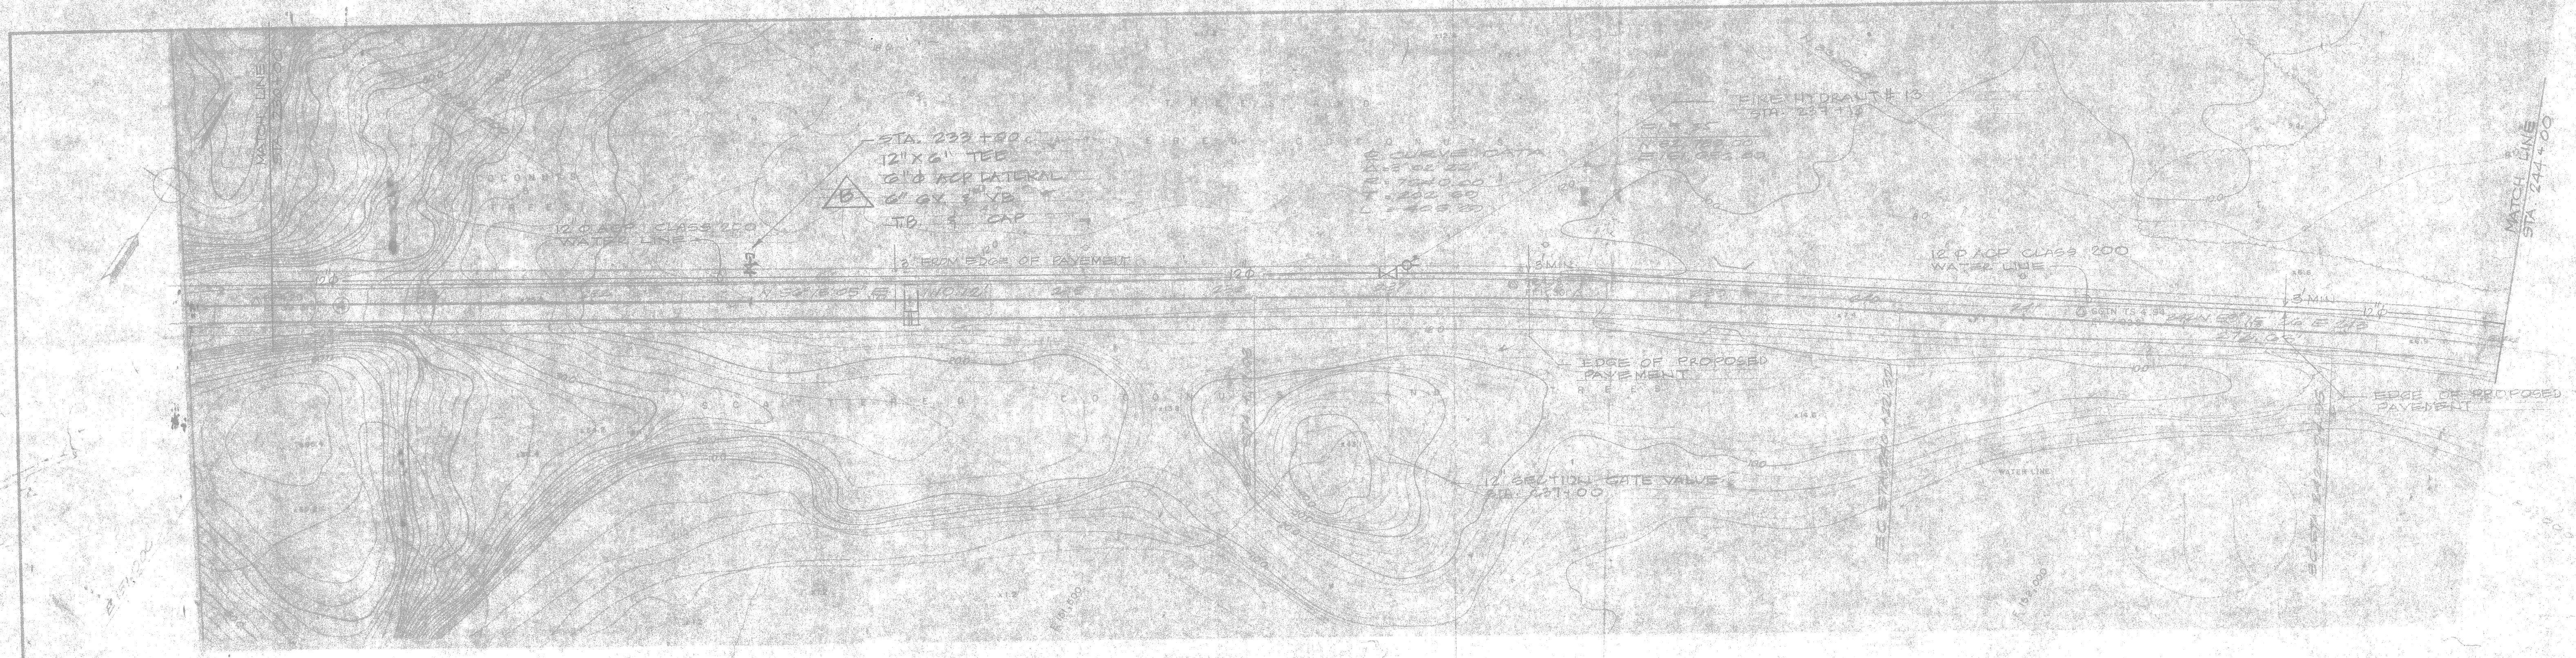


PLAN
SCALE: 1" = 50'-0"

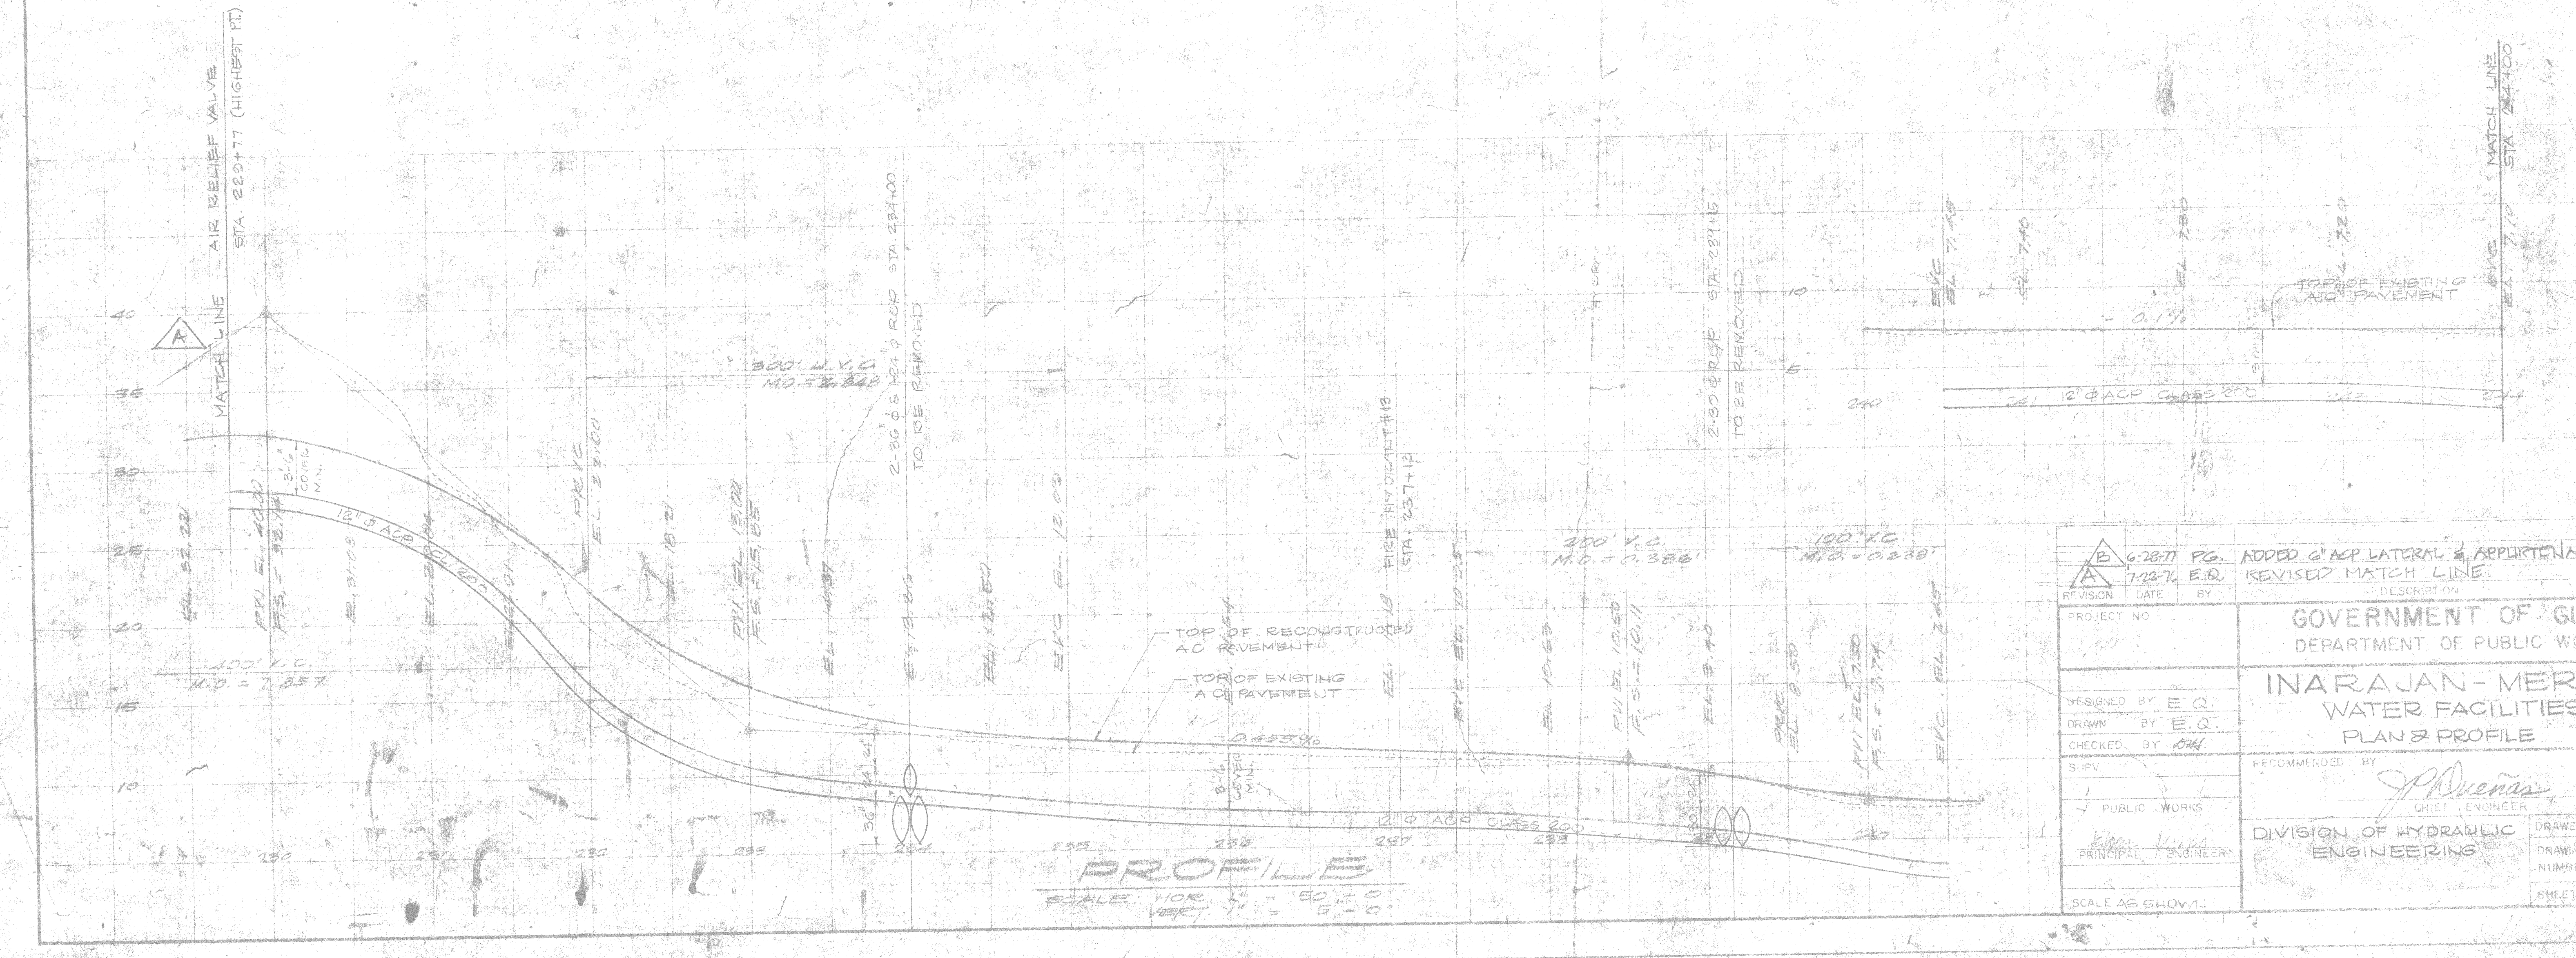

PROFILE
SCALE: HOR. 1" = 50'-0"
VERT. 1" = 5'-0"

<p>REVISION</p> <p>REVISION DATE BY DESCRIPTION</p> <p>A 7-12-76 E.Q. REVISED MATCH LINE.</p>	
<p>PROJECT NO. _____</p> <p>GOVERNMENT OF GUAM DEPARTMENT OF PUBLIC WORKS</p>	
<p>DESIGNED BY E.Q.</p> <p>DRAWN BY E.Q.</p> <p>CHECKED BY O.H.</p> <p>SHIP _____</p>	
<p>RECOMMENDED BY <i>J. P. Merizo</i> 3/10/76</p> <p>CHIEF ENGINEER</p> <p>DIVISION OF HYDRAULIC ENGINEERING</p>	
<p>SCALE AS SHOWN</p> <p>DRAWER NO. _____</p> <p>NUMBER 10</p> <p>SHEET 10.A OF 40</p>	

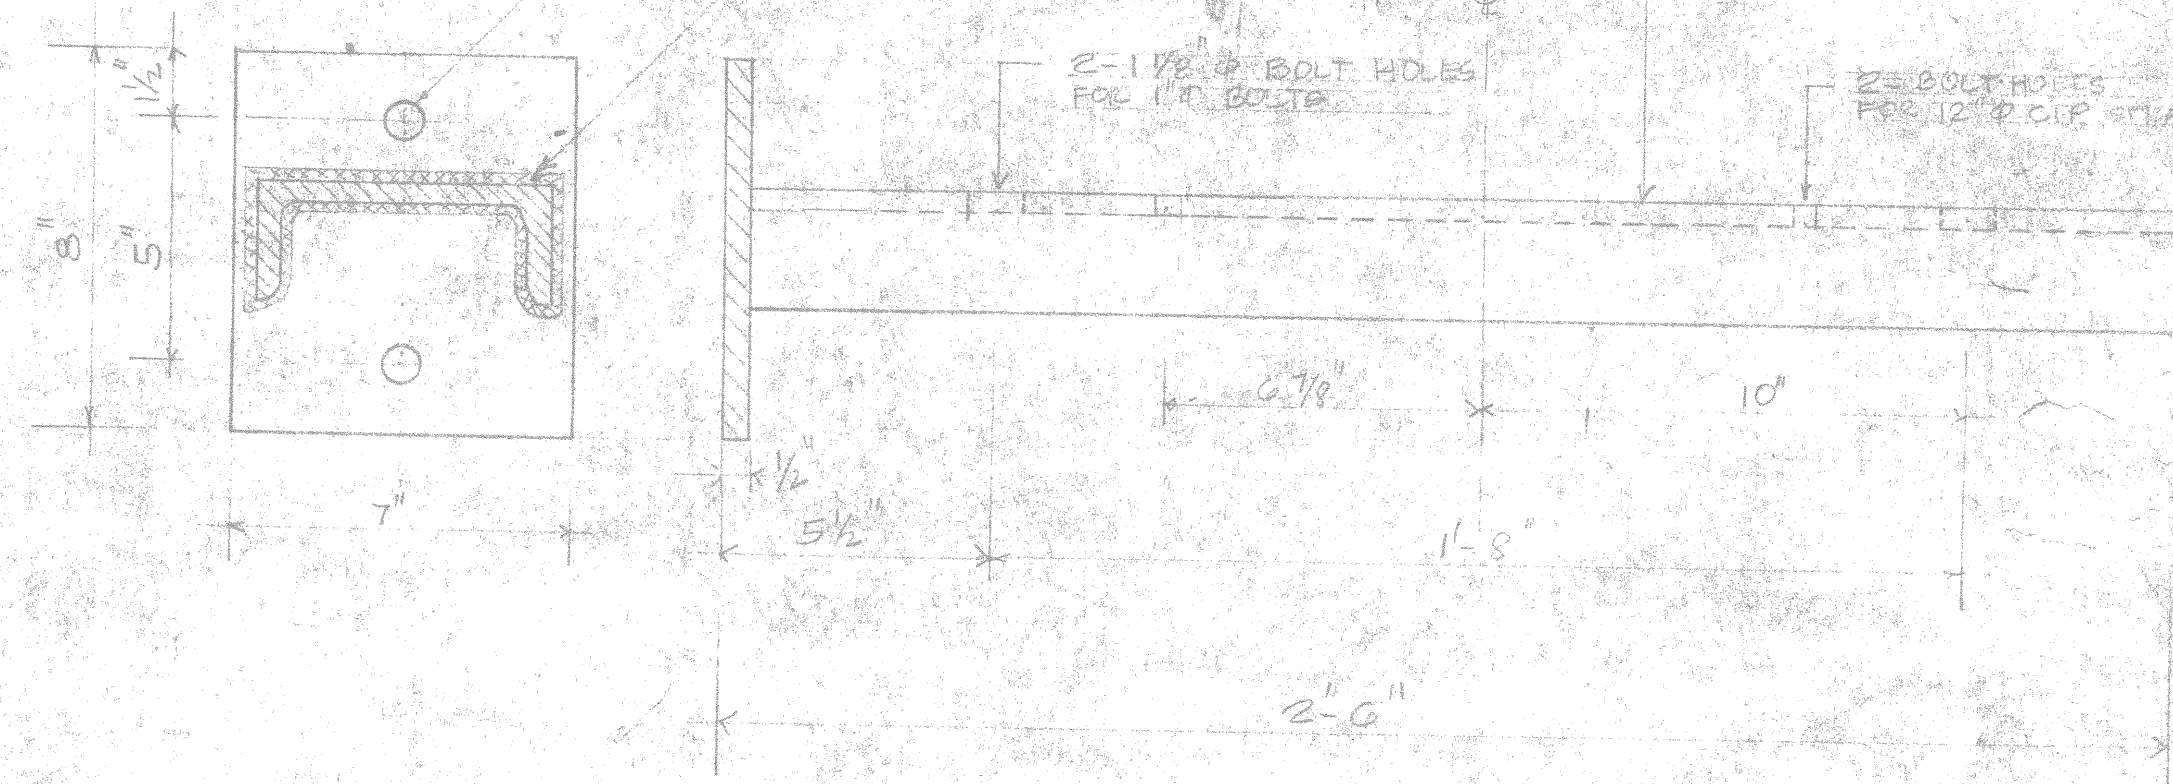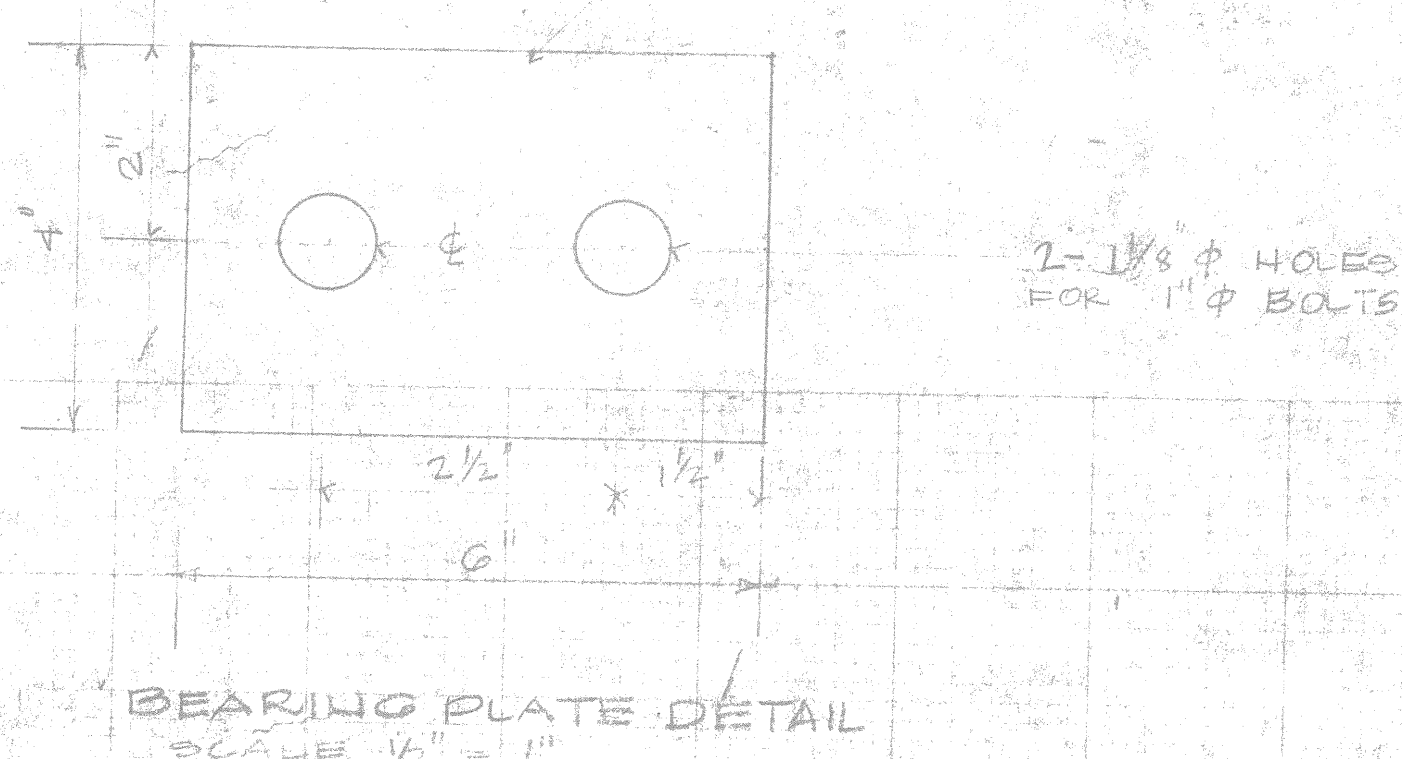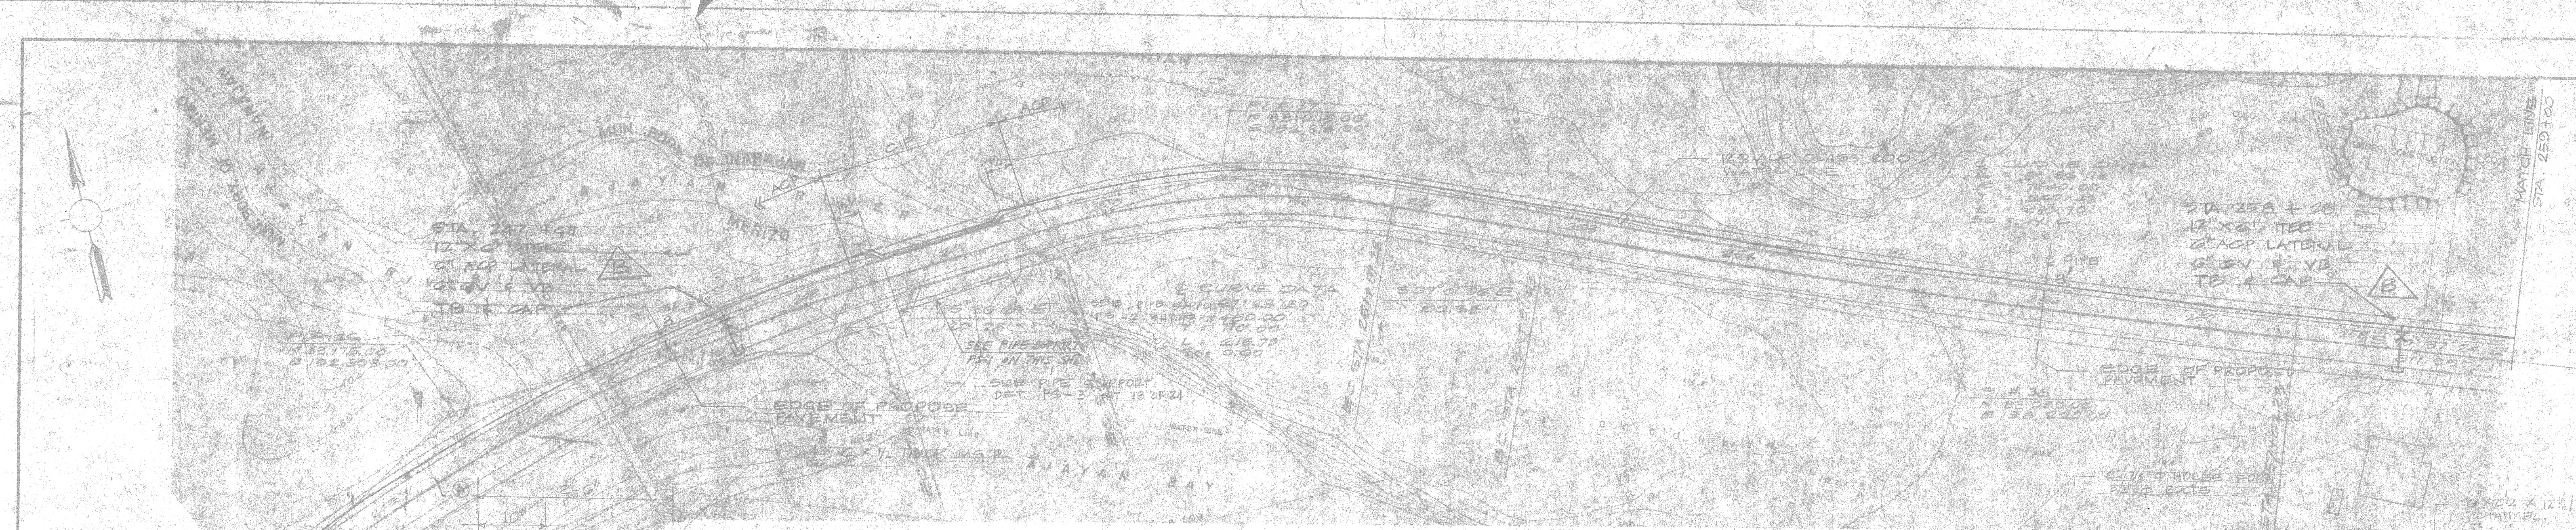

NOTE: (PIPE SUPPORT)
 1. PIPE SUPPORTS SHALL BE SPACED AT 5'-0" O.C.
 2. ALL MATERIALS SHALL BE GALVANIZED STEEL.

PIPE SUPPORT DETAIL (PS-2)
SCALE: 1" = 1'-0"

BEARING PLATE DETAIL
SCALE: 1/2" = 1"



REVISION	DATE	BY	DESCRIPTION	APPROVED
1			ADDED 6" ACP LATERAL & APPURTENANCES	
PROJECT NO. 618-71 PG			GOVERNMENT OF GUAM DEPARTMENT OF PUBLIC WORKS	
DESIGNED BY E.Q.			INARAJAN-MERIZO WATER FACILITIES	
DRAWN BY E.Q.			PLAN, PROFILE, PIPE SUPPORT DETAILS	
CHECKED BY [Signature]			RECOMMENDED BY [Signature] DATE: 3/10/76	
SUPV. PUBLIC WORKS			CHIEF ENGINEER	
PRINCIPAL ENGINEER			DIVISION OF HYDRAULIC ENGINEERING	
SCALE AS SHOWN			DRAWER NO. 17 NUMBER 17 OF 40 SHEET 17 OF 40	